



GENERAL NOTES:

1. THE INFORMATION PERTAINING TO EXISTING CONDITIONS SUCH AS LOCATIONS OF UTILITIES, EQUIPMENT, PIPING AND OTHER BUILDING CONDITIONS HAS BEEN BASED ON "AS-BUILT" RECORDS AND FIELD VERIFICATION WITH LIMITED ACCESS, LAYOUT AND DISTRIBUTION OF PIPING SHOWN MAY BE DIFFERENT THAN IN THE FIELD.
2. THE CONTRACTOR IS RESPONSIBLE FOR ALL CUTTING AND PATCHING REQUIRED FOR INSTALLATION OF PIPING AND ACCESSORIES. ALL PENETRATIONS THROUGH FIRE RATED WALLS AND FLOORS SHALL BE PROPERLY FIRESTOPPED. METHOD OF FIRESTOPPING SHALL BE REVIEWED AND APPROVED BY ENGINEER PRIOR TO INSTALLATION.
3. PLUMBING PIPING AND ACCESSORIES INDICATED AS DASHED SHALL BE DEMOLISHED. PROTECT ENDS OF PIPING FOR FUTURE RECONNECTION.
4. THE CONTRACTOR SHALL MAINTAIN SERVICE TO EXISTING UTILITIES WHICH SUPERSEDES ANY DEMOLITION OR REROUTING INDICATED. NOTIFY ENGINEER OF ANY CONFLICTS.
5. ITEMS TO BE REMOVED SHALL BECOME THE PROPERTY OF THE CONTRACTOR AND SHALL BE REMOVED FROM THE SITE, UNLESS NOTED OTHERWISE.
6. INFORMATION SHOWN SOLID, WITH LIGHT LINE/TYPE REFERENCES EXISTING CONDITIONS AND SHALL REMAIN UNLESS NOTED OTHERWISE.
7. THE CONTRACTOR SHALL COORDINATE ALL SHUT-DOWNS AND TIE-INS WITH OWNER PRIOR TO BEGINNING WORK. REFER TO SPECIFICATION SECTION 01000 GENERAL REQUIREMENTS FOR SHUT-DOWN REQUIREMENTS AN PROCEDURES.
8. CONTRACTOR TO SUBMIT ALL PIPE ROUTING TO THE A/E, COTR, AND PIPE SHOP PRIOR TO CONSTRUCTION.

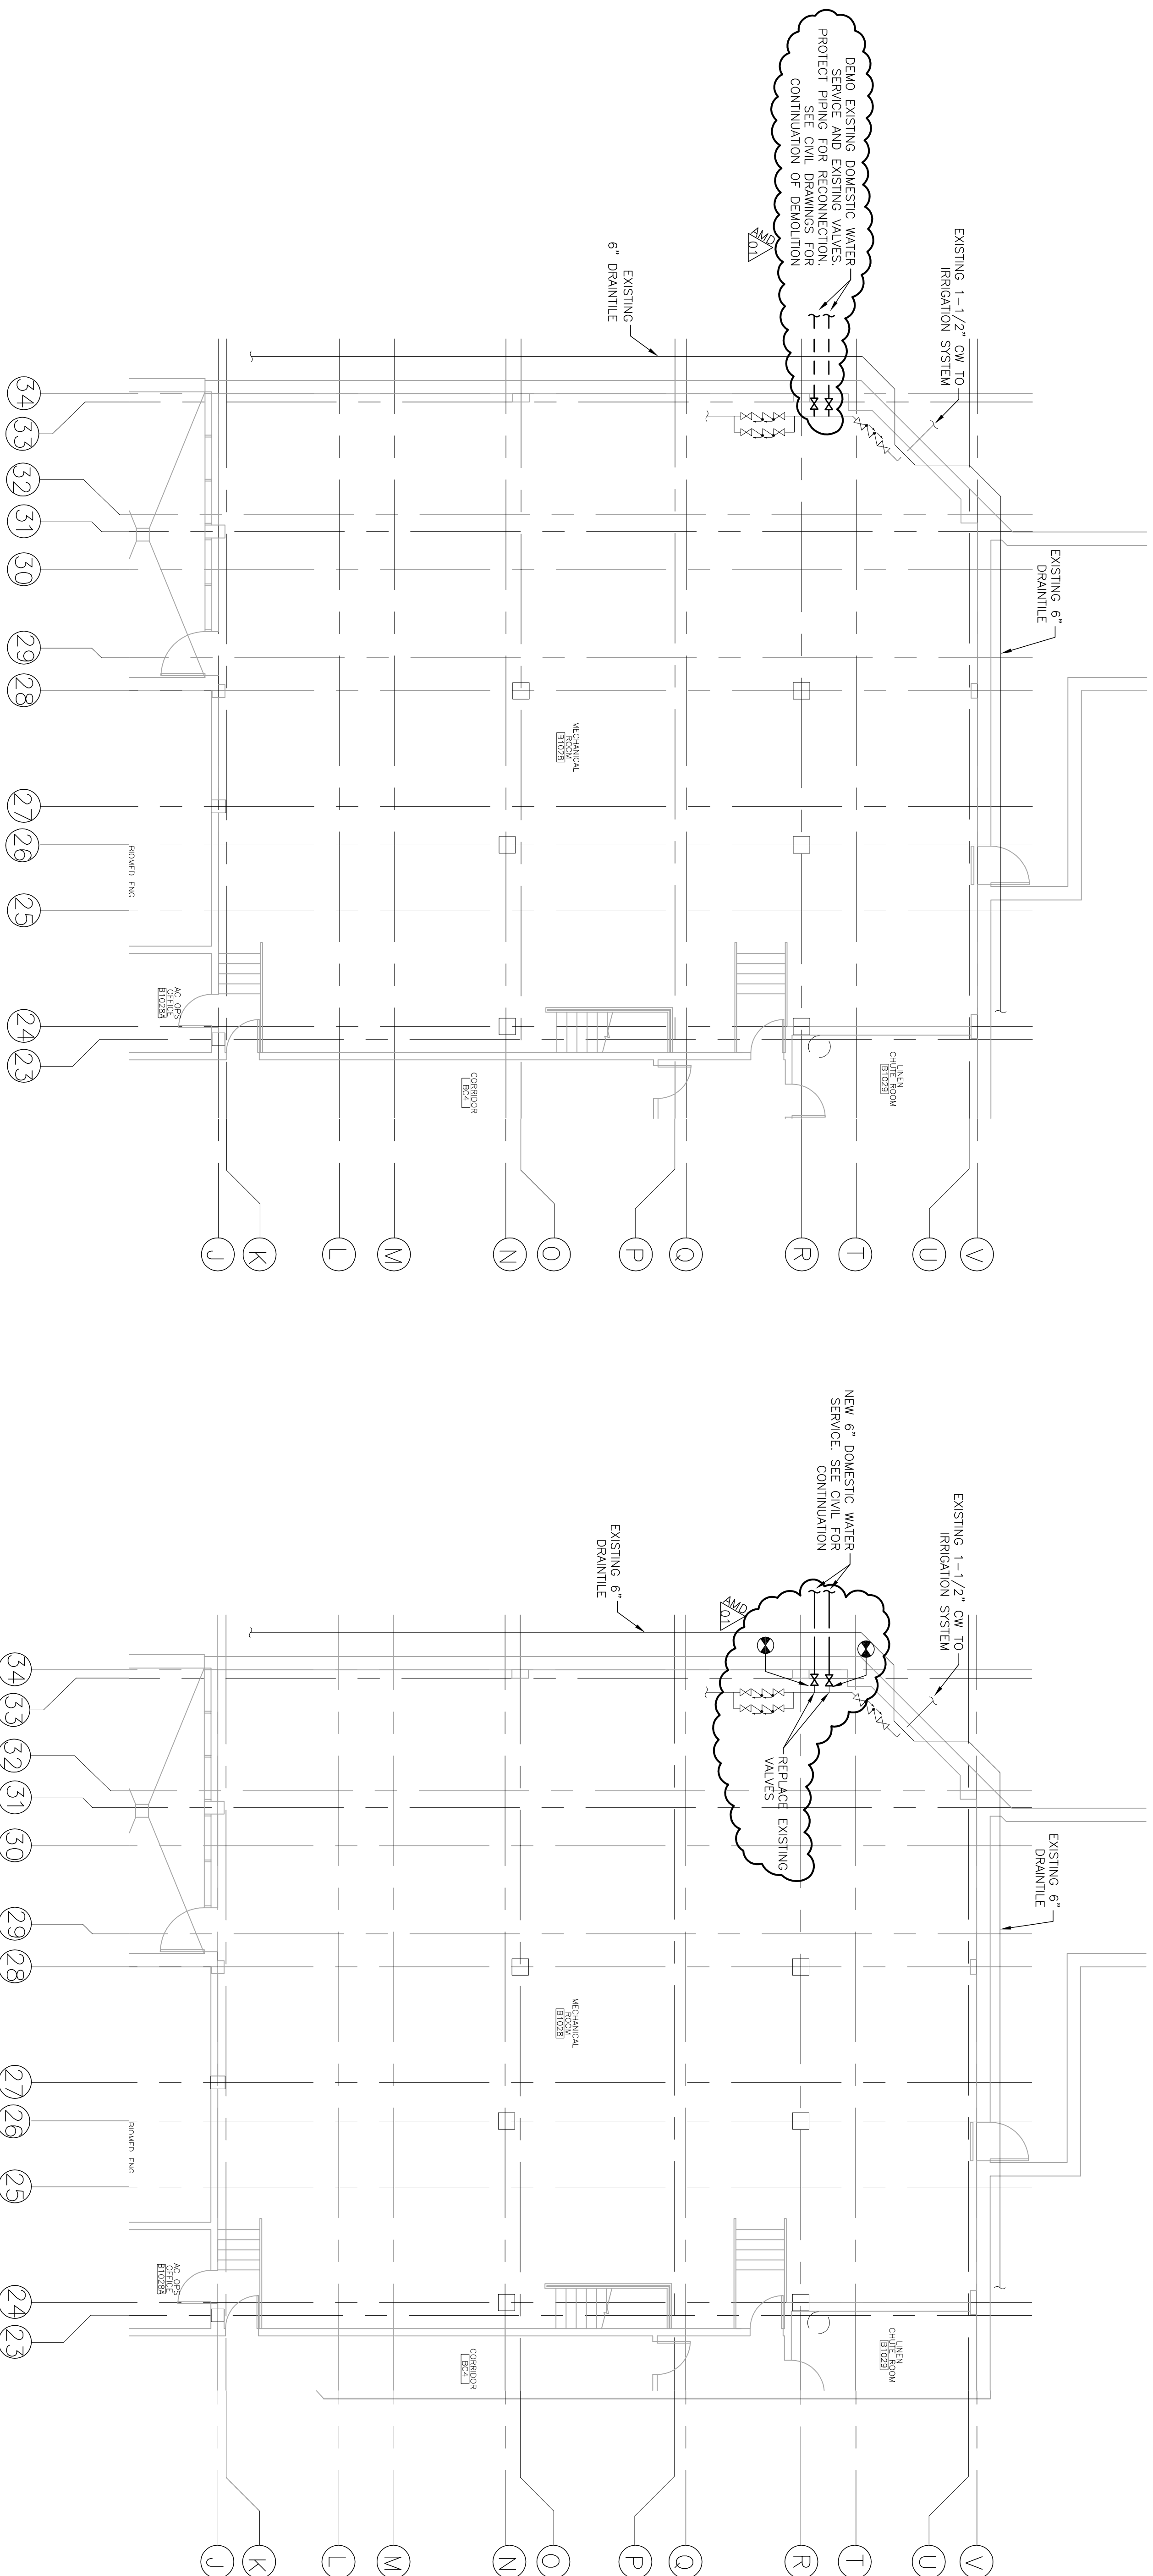

1 DOMESTIC WATER DEMO PLAN (BUILDING 228)  
1/8" = 1'-0"

2 DOMESTIC WATER PLAN (BUILDING 228)  
1/8" = 1'-0"  $\angle$

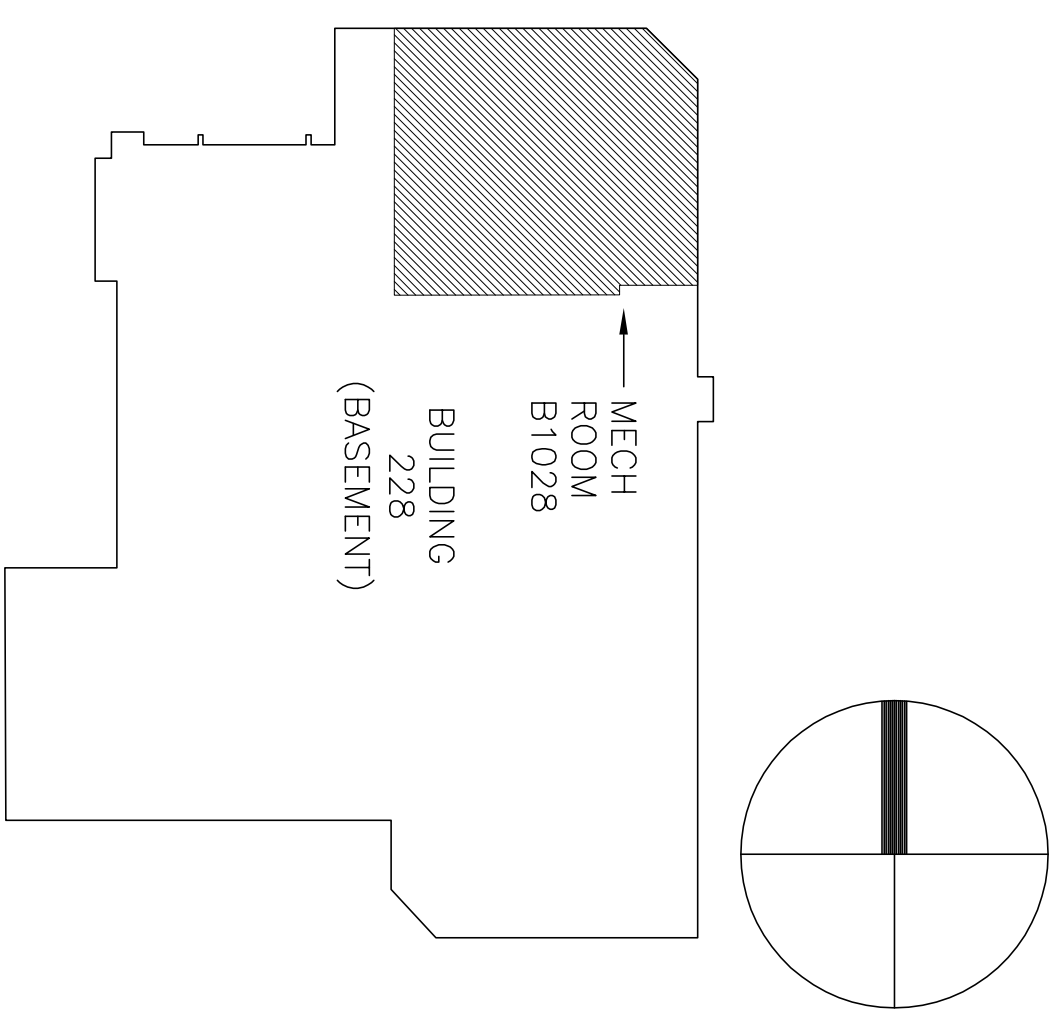[illegible]